


SUITE G
MEZZANINE PLAN
380 USF

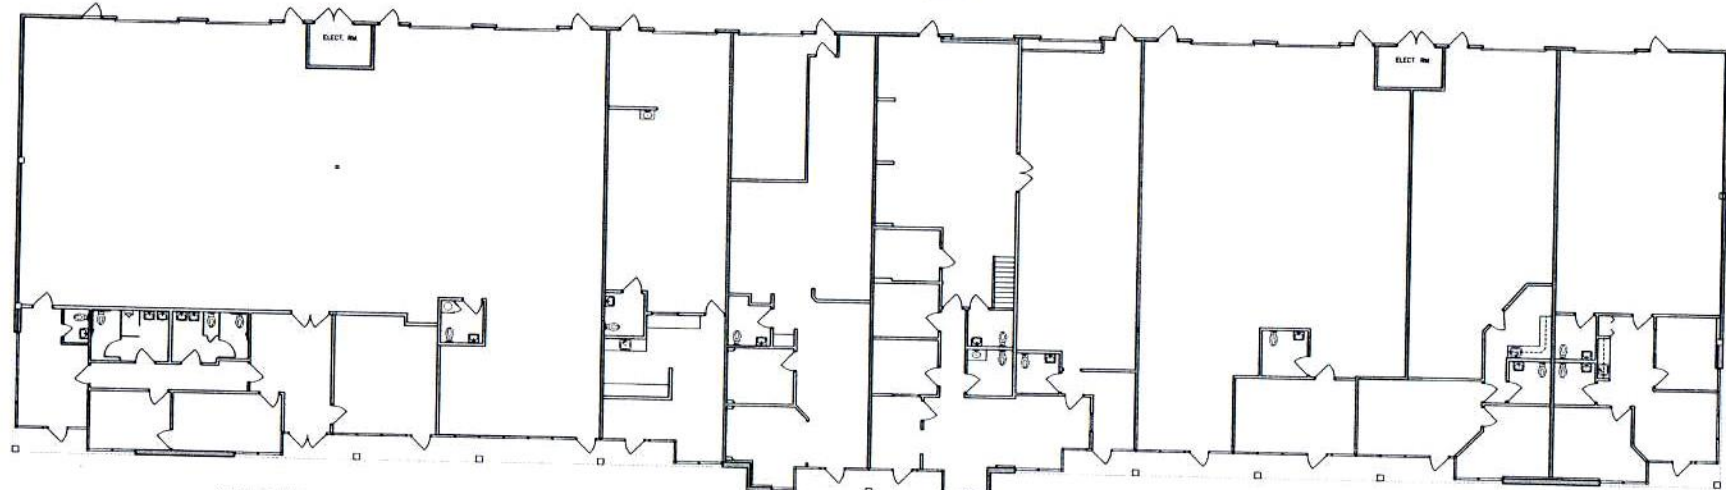

SUITE A/B/C/D
6,532 USF
6,891 RSF

SUITE E
1,383 USF
1,435 RSF

SUITE F
1,763 USF
1,813 RSF

SUITE G
1,730 USF
1,780 RSF

SUITE H
1,415 USF
1,467 RSF

SUITE I/J
2,846 USF
3,036 RSF

SUITE K
1,765 USF
1,870 RSF

SUITE L
1,958 USF
2,018 RSF

GROSS AREA: 19,654 SF
TOTAL USEABLE AREA: 19,392 SF
TOTAL RENTABLE AREA: 20,310 SF

NOTES:
SQUARE FOOTAGES INDICATED ARE BASED ON
NUMBERS PROVIDED TO WARE MALCOMB
RENTABLE SQUARE FOOTAGES INCLUDE OVERHANGS
AND COMMON AREAS (ELECTRICAL ROOMS)

0 8' 32'
4' 16'
scale: 1/8" = 1'-0"



CORPORATE BUSINESS CENTER
A Masterplanned Office and Industrial Park

10444 BUILDING
LOMA LINDA, CA

CORPORTE BUSINESS CENTER
ASBUILT PLANS

1
IEE11-6007-01
07.14.2011

WARE MALCOMB
Leading Design for Commercial Real Estate
integrated service
across north america | waremalcomb.com